



PREPARED FOR:

ARCHITECT
PLANNING

PROJECT TYPE


FOUNDATION
PLAN

PROJECT NAME


SMITH
RESIDENCE

PROJECT ADDRESS

1234 CHERRY TREE
BOULEVARD
LONG BEACH, CA 90800

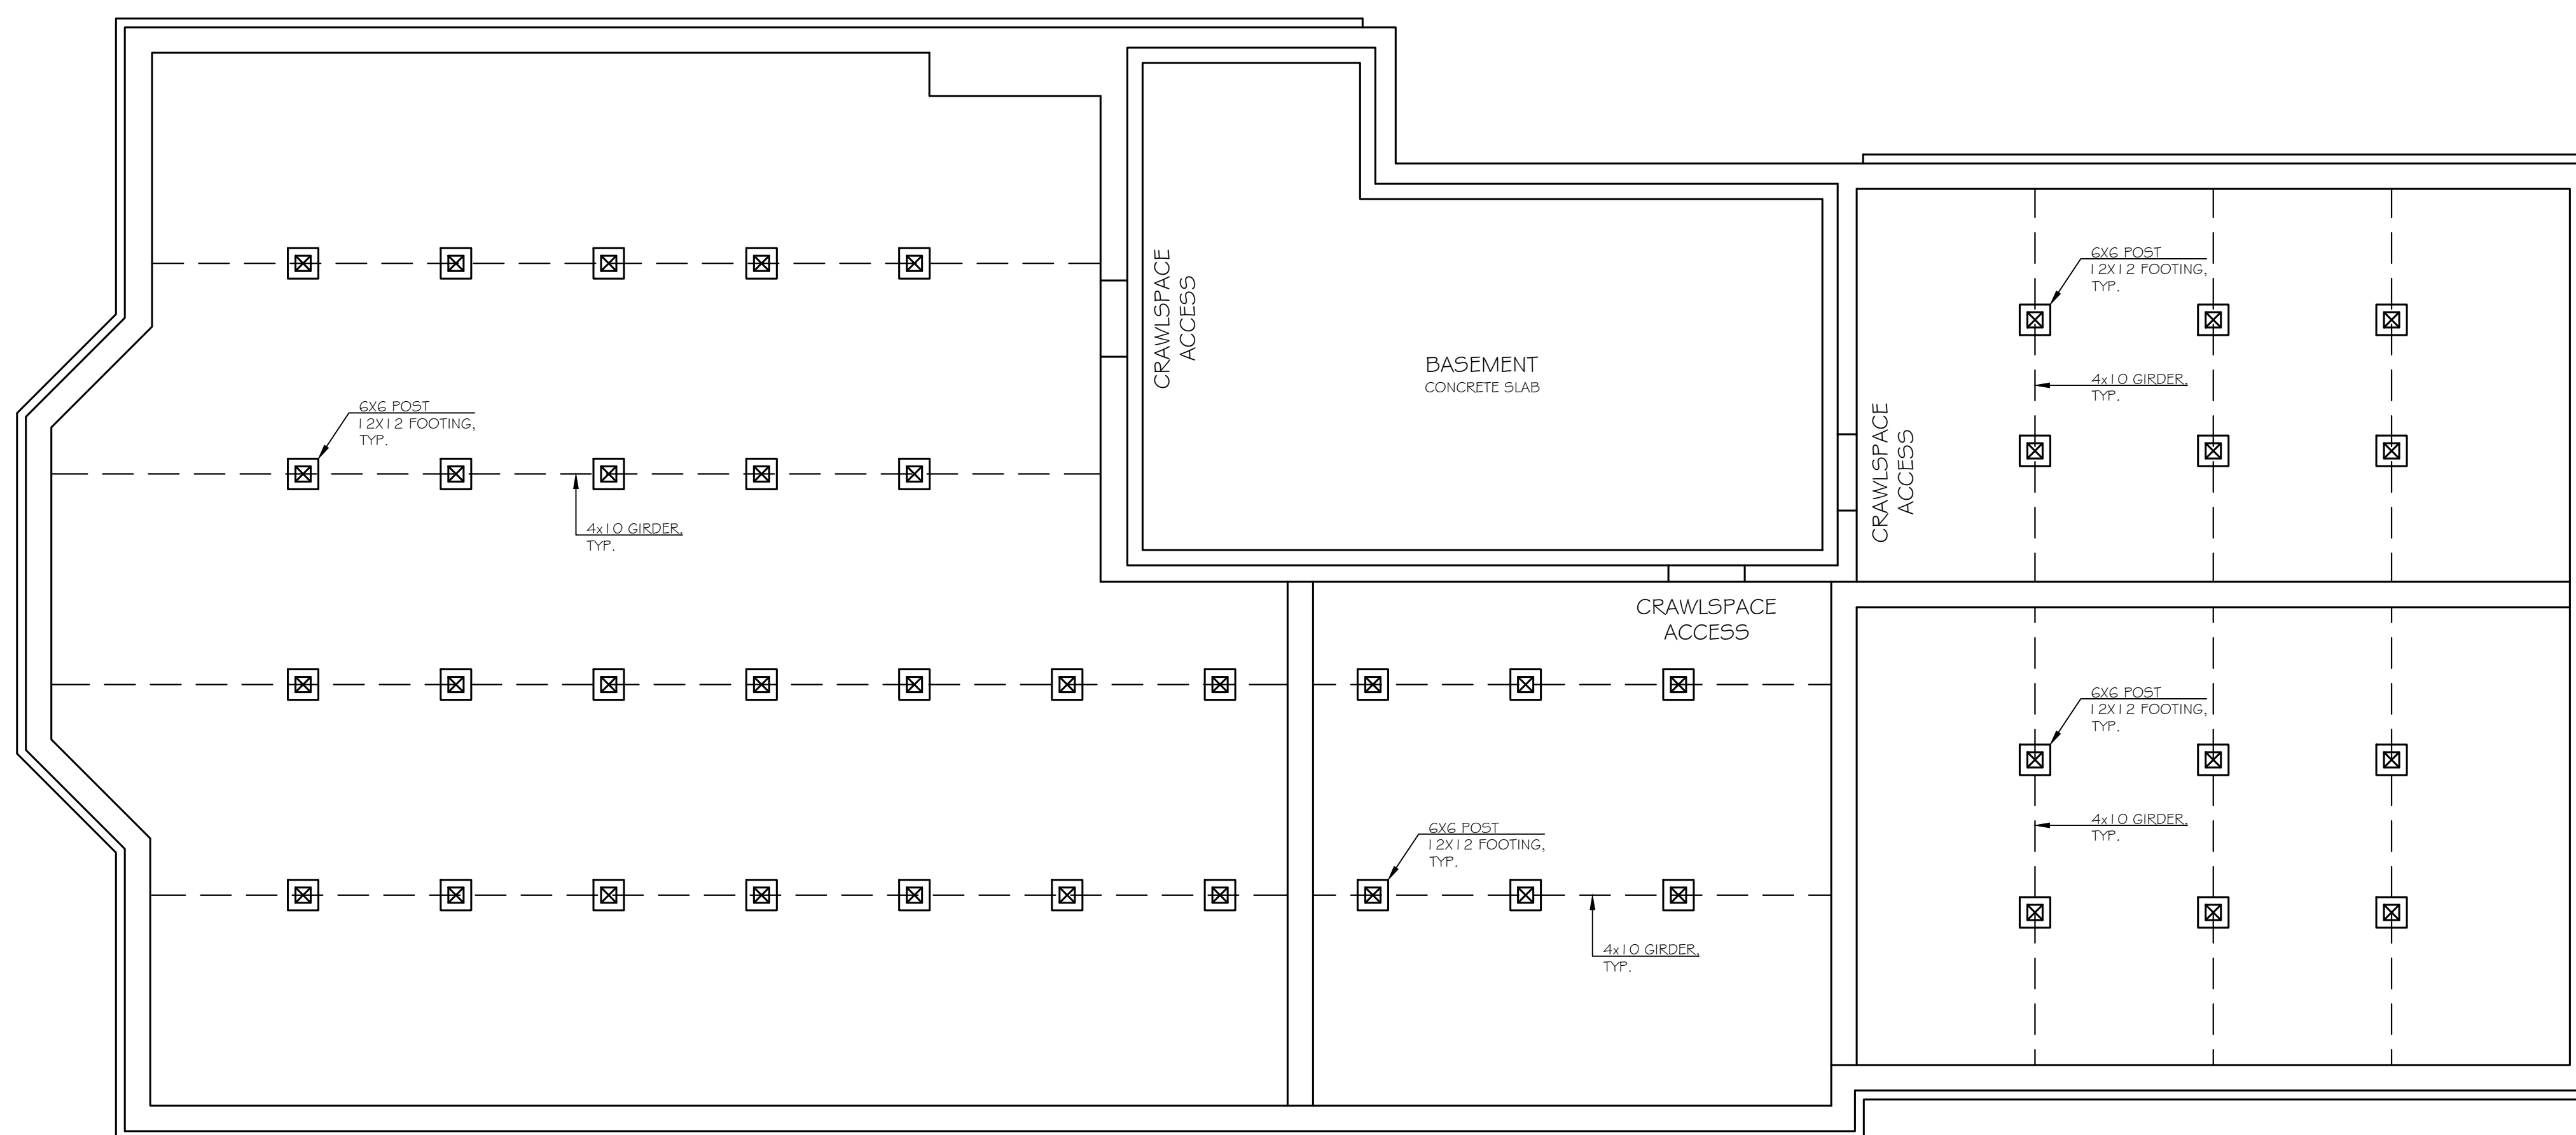

All plans created by Precision Property Measurements Ltd (PPM) are made exclusively for the building purposes (Cal. Civ. & Prof. Code §2722). All site plans created by PPM do not include the determination of any property line, and such does not constitute a surveying. (Cal. Civ. & Prof. Code §2712-2713). In addition, PPM services and plans do not constitute and should not be used for any structure or activities without the approval of a licensed professional engineer (Cal. Civ. & Prof. Code §26702-26704). All floor plans created by PPM are intended to be used as a reference for design and construction and should not be considered a substitute for the services of a licensed structural engineer or licensed architect. PPM makes every reasonable effort to ensure the accuracy of the information found in our plans. However, every Architect, planning, engineering, contractor, designer or other licensed professional, in a consultation with the property owner, to determine the suitability of the site before proceeding with construction. Measurements should be field checked before construction. In the event that an error is found on a plan, PPM's liability is limited to the amount of the fee paid to PPM.

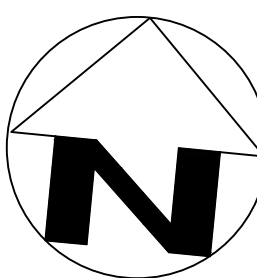

SCALE
1/4" = 1'-0"

PROJECT
12345

APPROVED BY
CT

DATE
9/18/19

SHEET
2 of 17

*NOTE: FRAMING SHOWN FOR VISUAL REFERENCE ONLY.

