

- SOFFIT LINE
- BEAM LINE
- ⊠ = CEILING DUPLEX
- ⊠ = CEILING QUADRAPLEX
- = ROUND SPEAKER
- ⊠ = SQUARE SPEAKER
- ⊠ = EXHAUST FAN w/ LIGHT
- ⊠ = EXHAUST FAN w/ LIGHT
- ⊠ = CEILING FAN w/ LIGHT
- ⊠ = CEILING FAN w/ LIGHT
- ⊠ = FLUORESCENT LIGHT
- ⊠ = TRACK LIGHTING
- ⊠ = CEILING MOUNTED FIXTURE
- ⊠ = RECESSED FIXTURE
- ⊠ = HANGING FIXTURE
- ⊠ = WALL MOUNTED FIXTURE
- ⊠ = CEILING J-BOX
- ⊠ = MOTION DETECTOR
- ⊠ = MISC. EQUIPMENT
- ⊠ = DOME SECURITY CAMERA
- ⊠ = WIFI BOOSTER
- ⊠ = CEILING MOUNTED CAMERA
- ⊠ = COVER PLATE
- ⊠ = GARAGE DOOR OPENER
- ⊠ = HVAC SUPPLY VENT
- ⊠ = HVAC RETURN VENT
- ⊠ = CEILING HATCH
- ⊠ = SMOKE ALARM
- ⊠ = STROBE LIGHT
- EXIT = EXIT SIGN
- ⊠ = EMERGENCY LIGHT w/o EXIT
- ⊠ = EMERGENCY LIGHT w/ EXIT
- ⊠ = SPRINKLER
- ⊠ = HEAT DETECTOR

3626 E. PACIFIC COAST
HIGHWAY | 2ND FLOOR
LONG BEACH CA | 90804
T 562.621.9100
F 888.698.2966
WWW.PPMCO.NET



PREPARED FOR

CLIENT

PLAN TYPE

REFLECTED
CEILING PLAN


PROJECT NAME

OFFICE
CLASS A
SAMPLE

PROJECT ADDRESS

1234 PRECISION
BOULEVARD
CITY, CA 00000

All plans created by Precision Property Measurements, LLC ("PPM") are made exclusively for the purposes of the project. PPM does not warrant the accuracy of the information provided on these plans. PPM makes every reasonable effort to ensure the accuracy of the information provided on these plans. However, there are no guarantees. PPM makes every reasonable effort to ensure the accuracy of the information provided on these plans. However, there are no guarantees. PPM makes every reasonable effort to ensure the accuracy of the information provided on these plans. However, there are no guarantees.

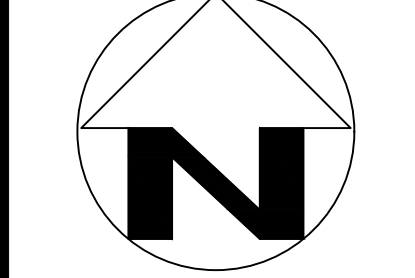



SCALE
1/8" = 1'-0"

PROJECT
XXXX_XX

APPROVED BY
XX

DATE
XX/XX/XX

SHEET

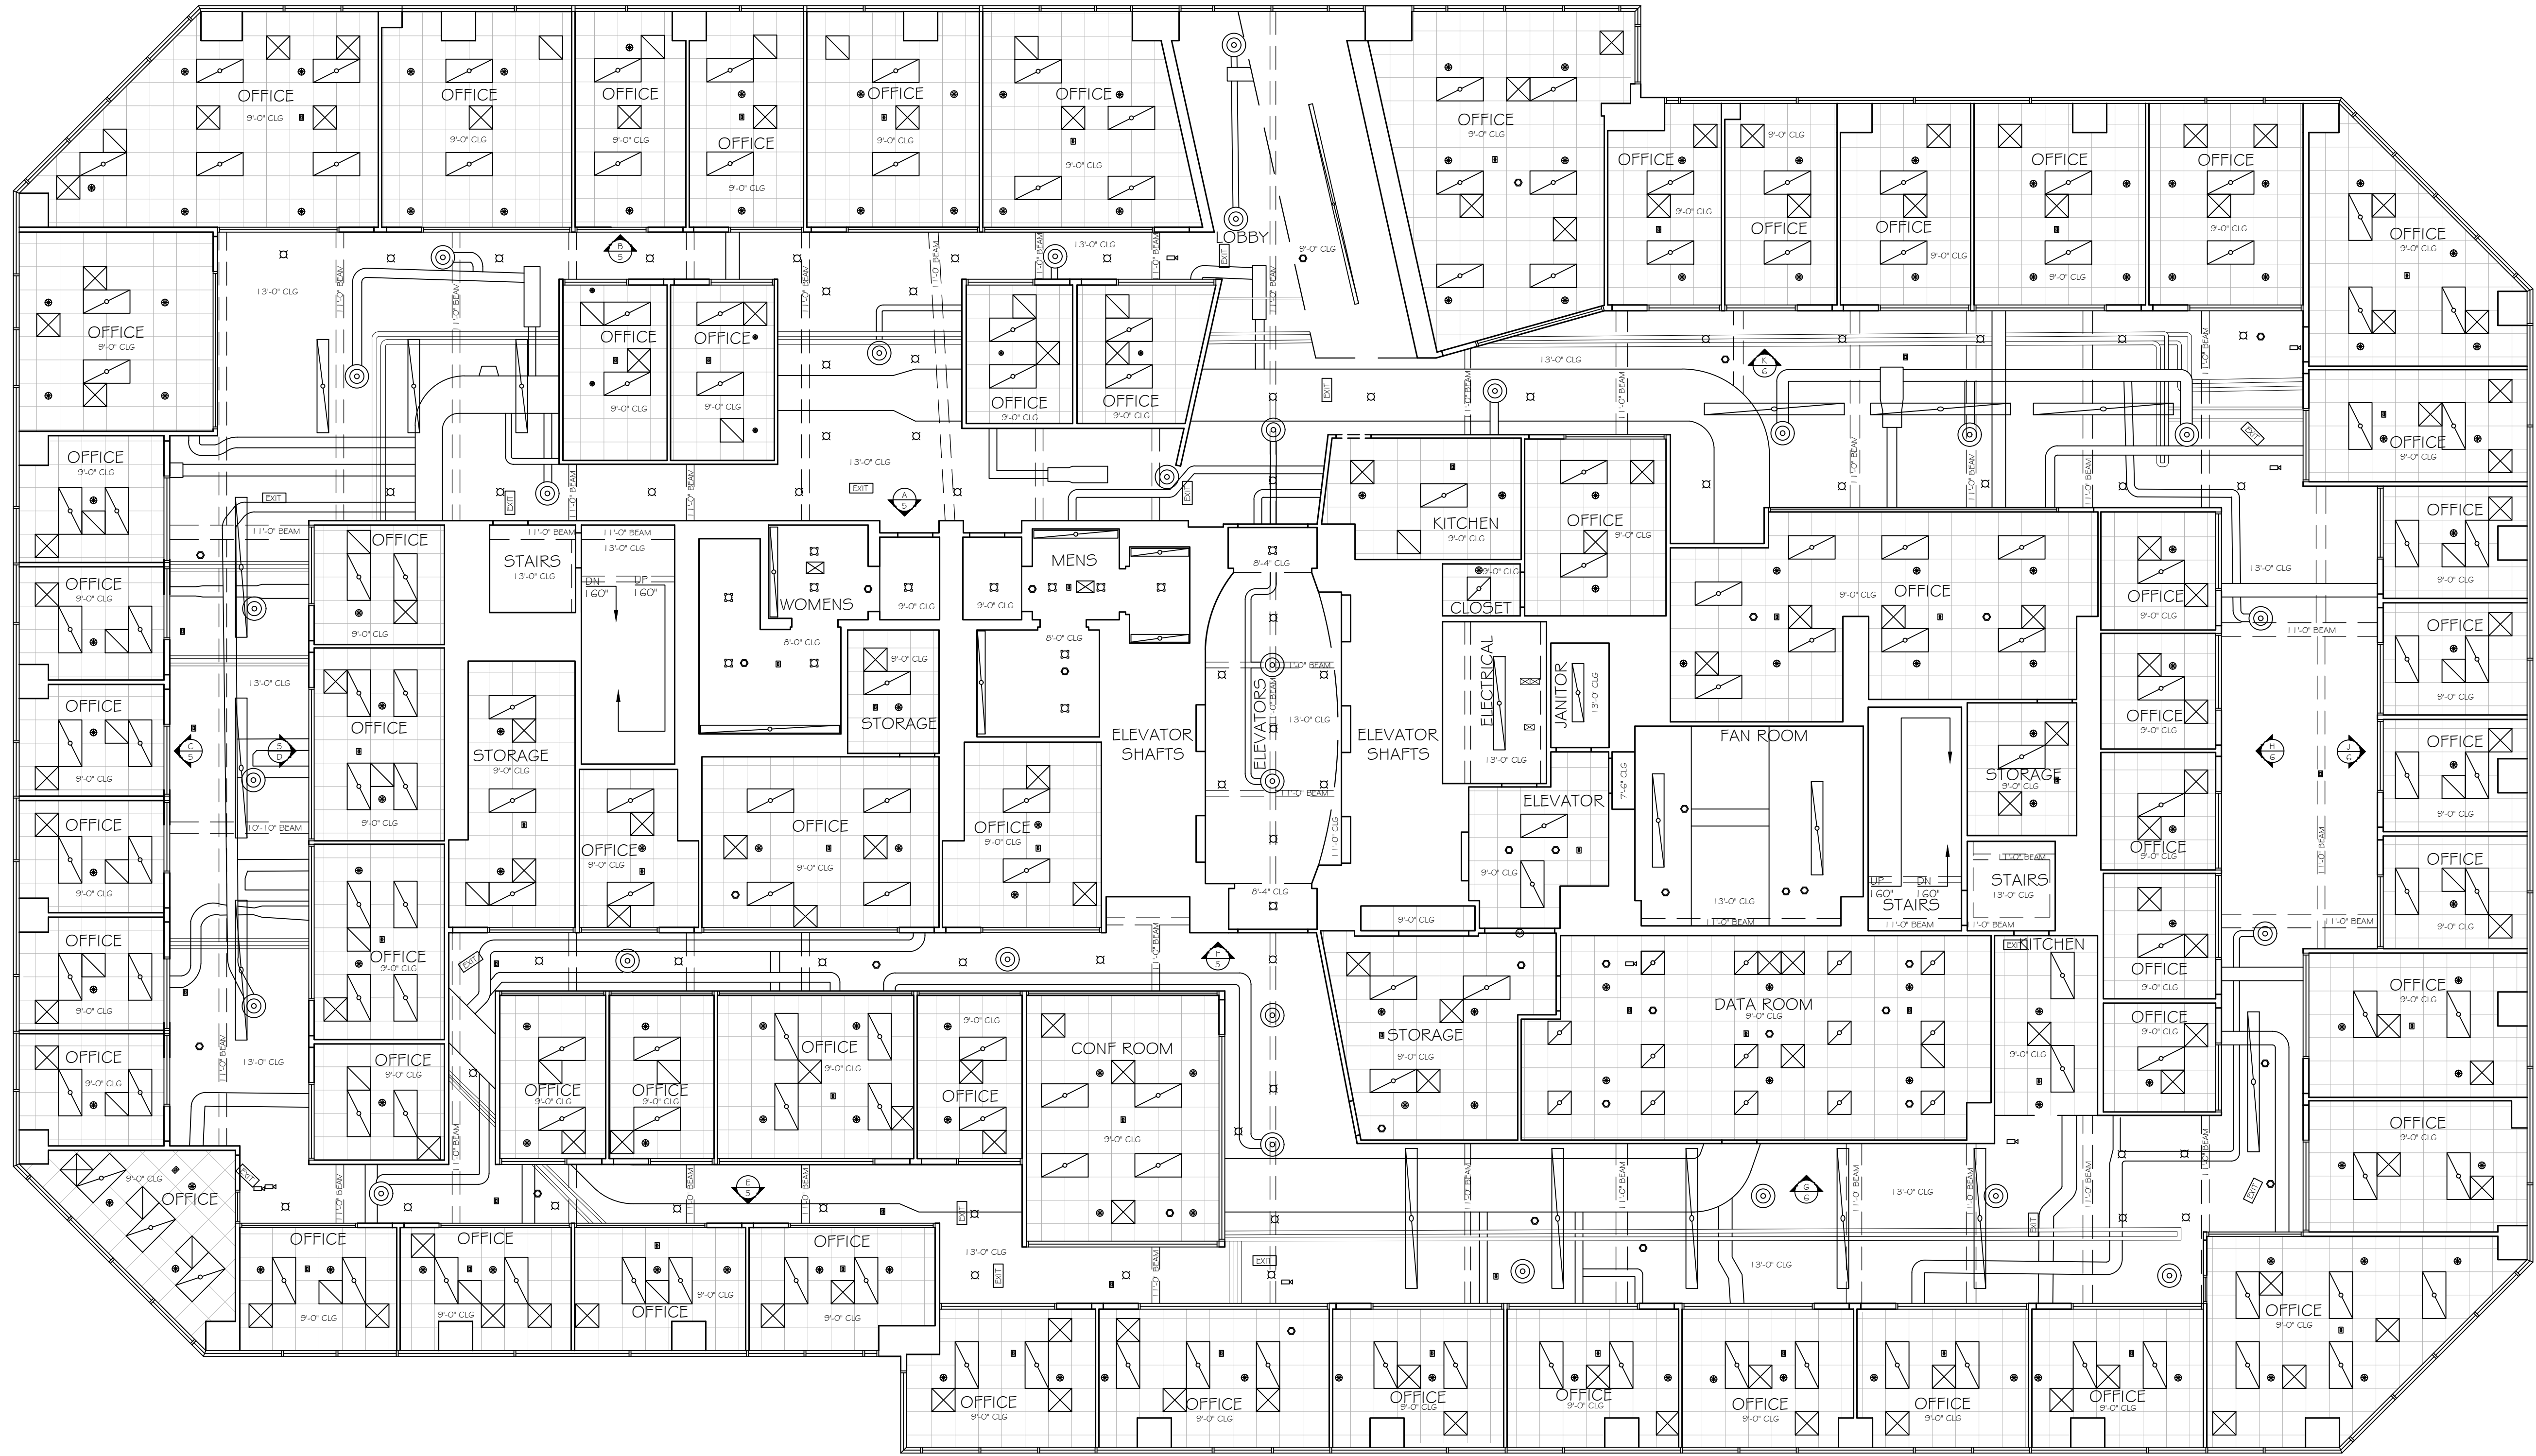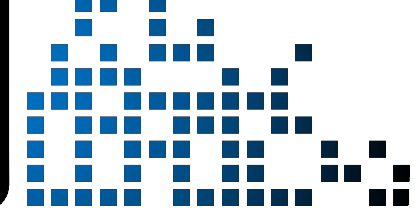

4TH FLOOR



PREPARED FOR

CLIENT

REFLECTED
CEILING PLAN

PROJECT NAME

PROJECT ADDRESS

1234 PRECISION
BOULEVARD
CITY, CA 00000

SCALE

1/8" = 1'-0"

PROJECT

XXXX_XX

APPROVED BY


XX

DATE


XX/XX/XX

SHEET

4 of 7

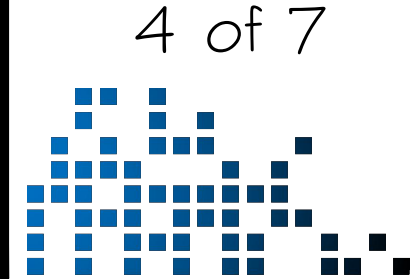

- SOFFIT LINE
- BEAM LINE
- CEILING DUPLEX
- CEILING QUADRAPLEX
- ROUND SPEAKER
- SQUARE SPEAKER
- EXHAUST FAN w/ LIGHT
- EXHAUST FAN w/o LIGHT
- CEILING FAN w/o LIGHT
- CEILING FAN w/ LIGHT
- FLUORESCENT LIGHT
- TRACK LIGHTING
- CEILING MOUNTED FIXTURE
- RECESSED FIXTURE
- HANGING FIXTURE
- WALL MOUNTED FIXTURE
- CEILING J-BOX
- MOTION DETECTOR
- MISC. EQUIPMENT
- DOME SECURITY CAMERA
- WIFI BOOSTER
- CEILING MOUNTED CAMERA
- COVER PLATE
- GARAGE DOOR OPENER
- HVAC SUPPLY VENT
- HVAC RETURN VENT
- ROUND SUPPLY VENT
- CEILING HATCH
- SMOKE ALARM
- STROBE LIGHT
- EXIT SIGN
- EMERGENCY LIGHT w/o EXIT
- EMERGENCY LIGHT w/ EXIT
- SPRINKLER
- HEAT DETECTOR

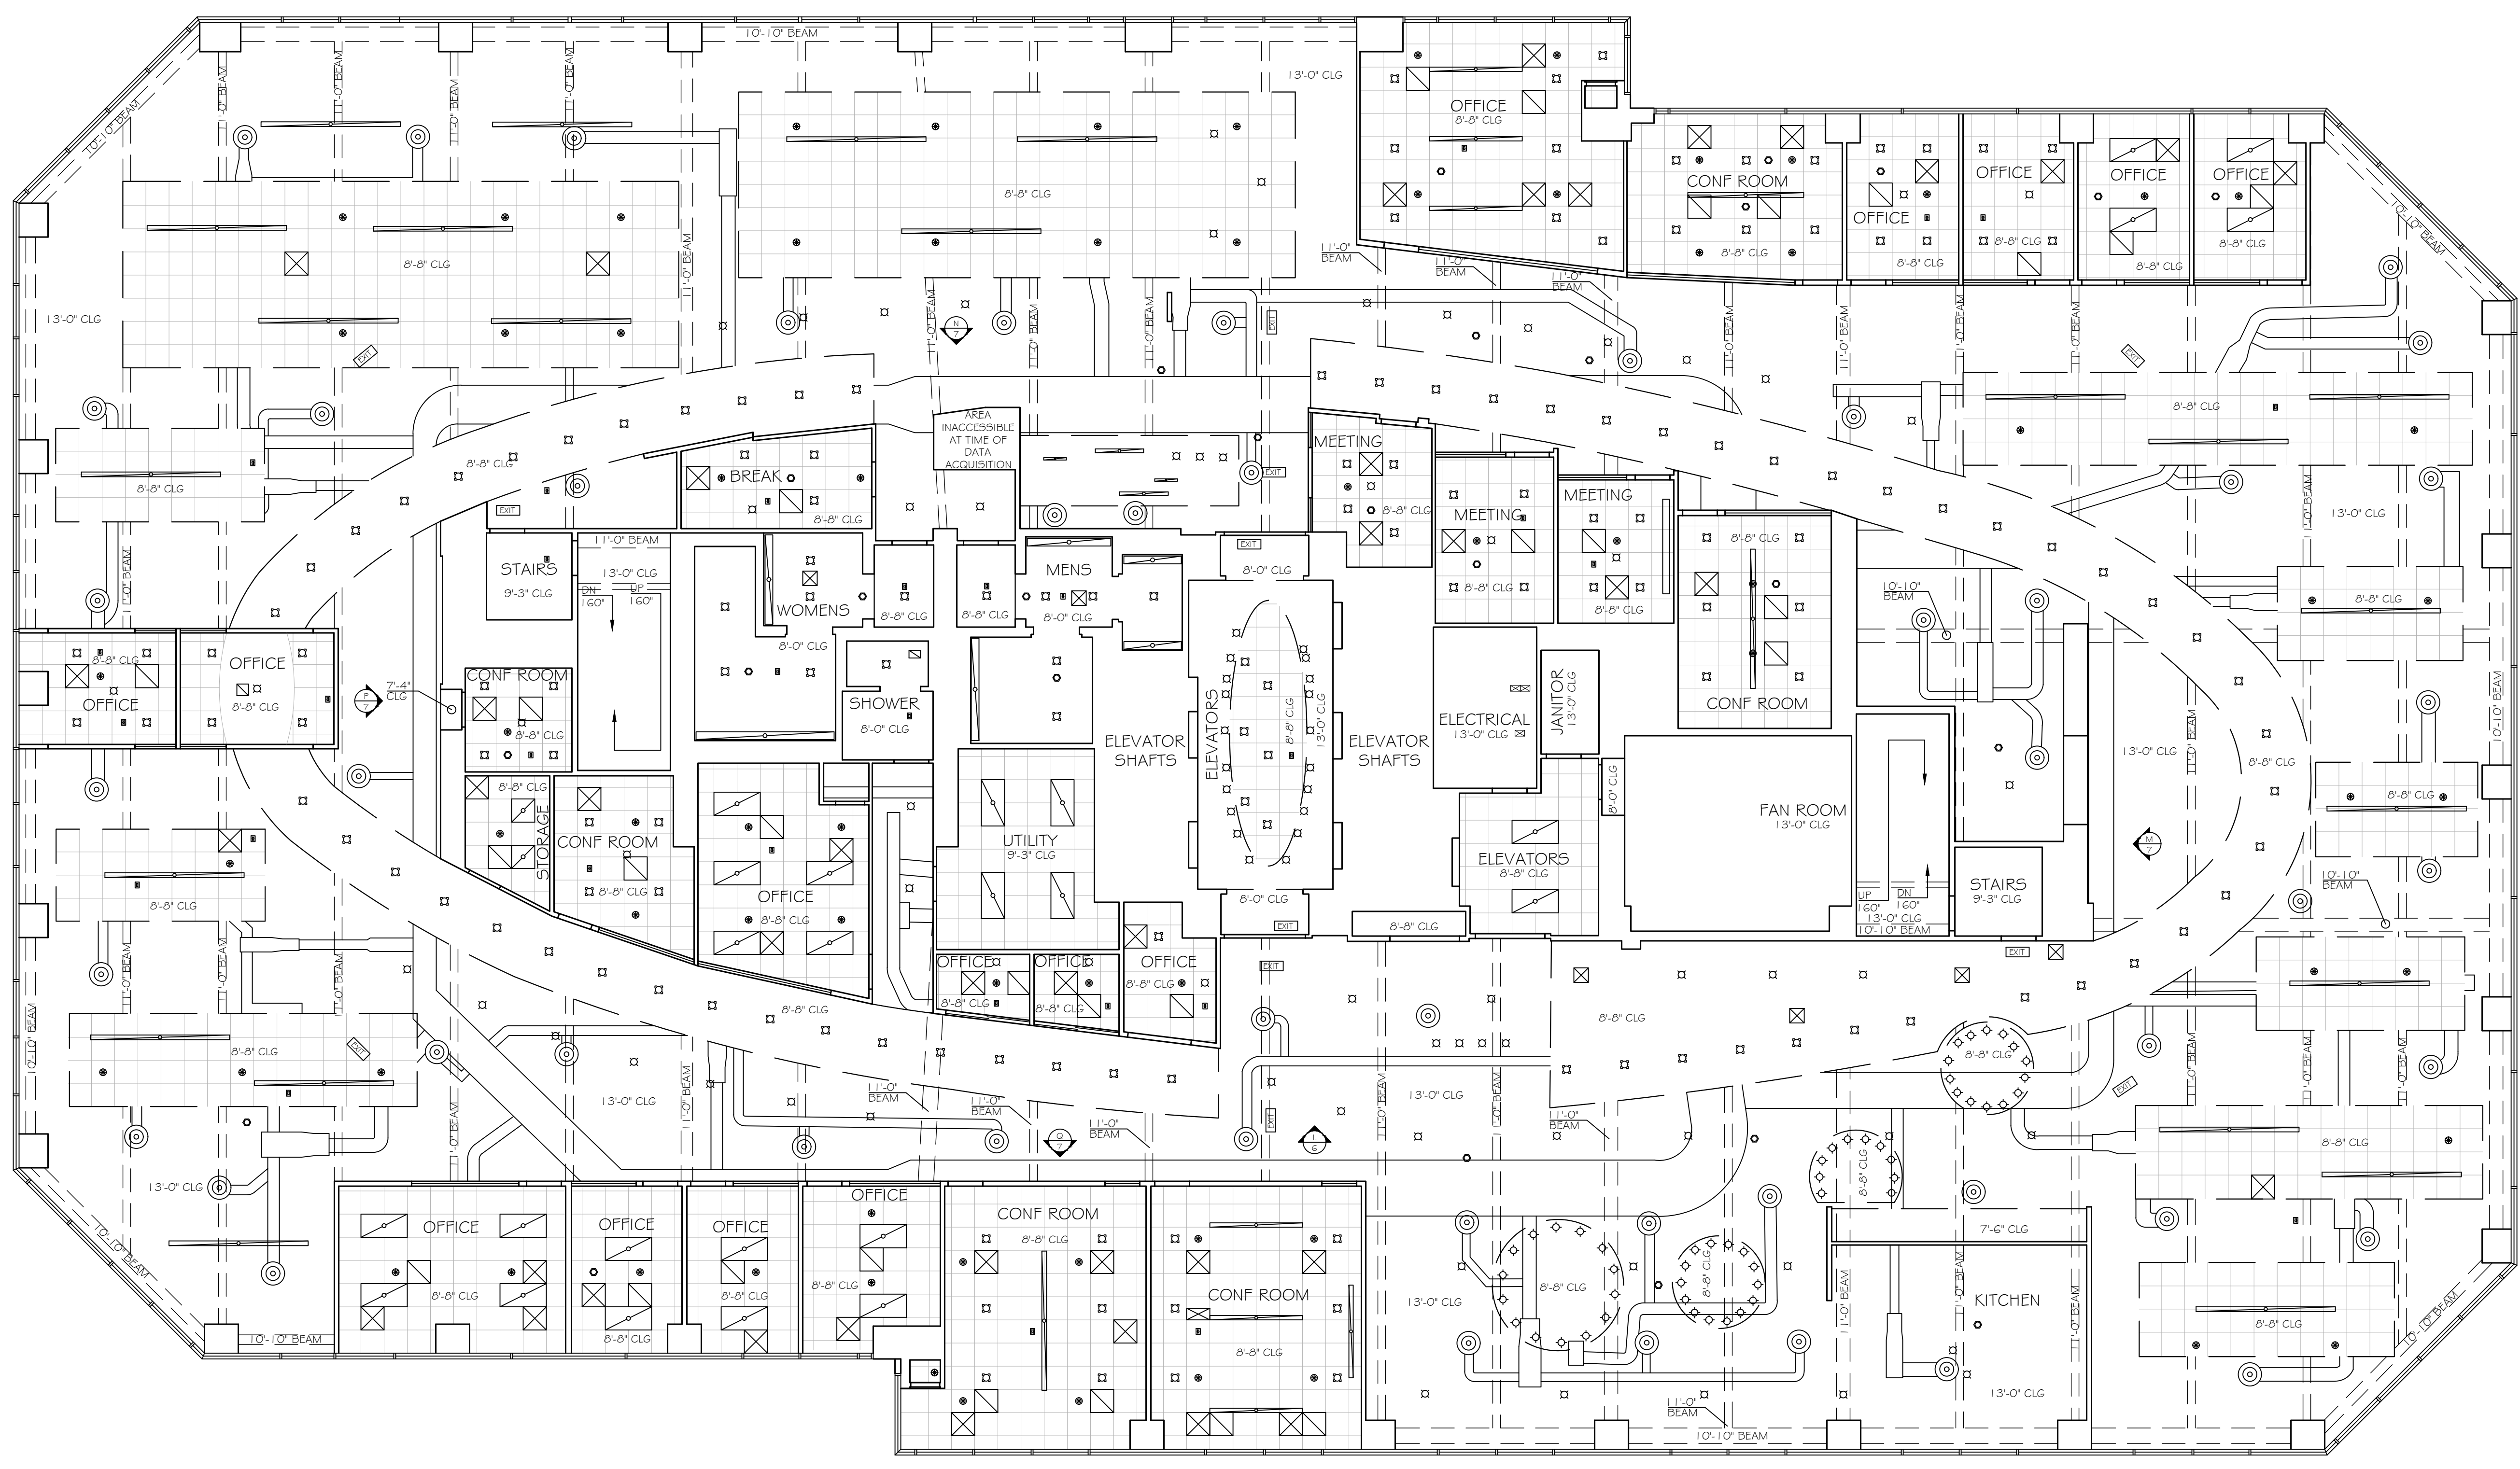

5TH FLOOR