




① SOUTH ELEVATION

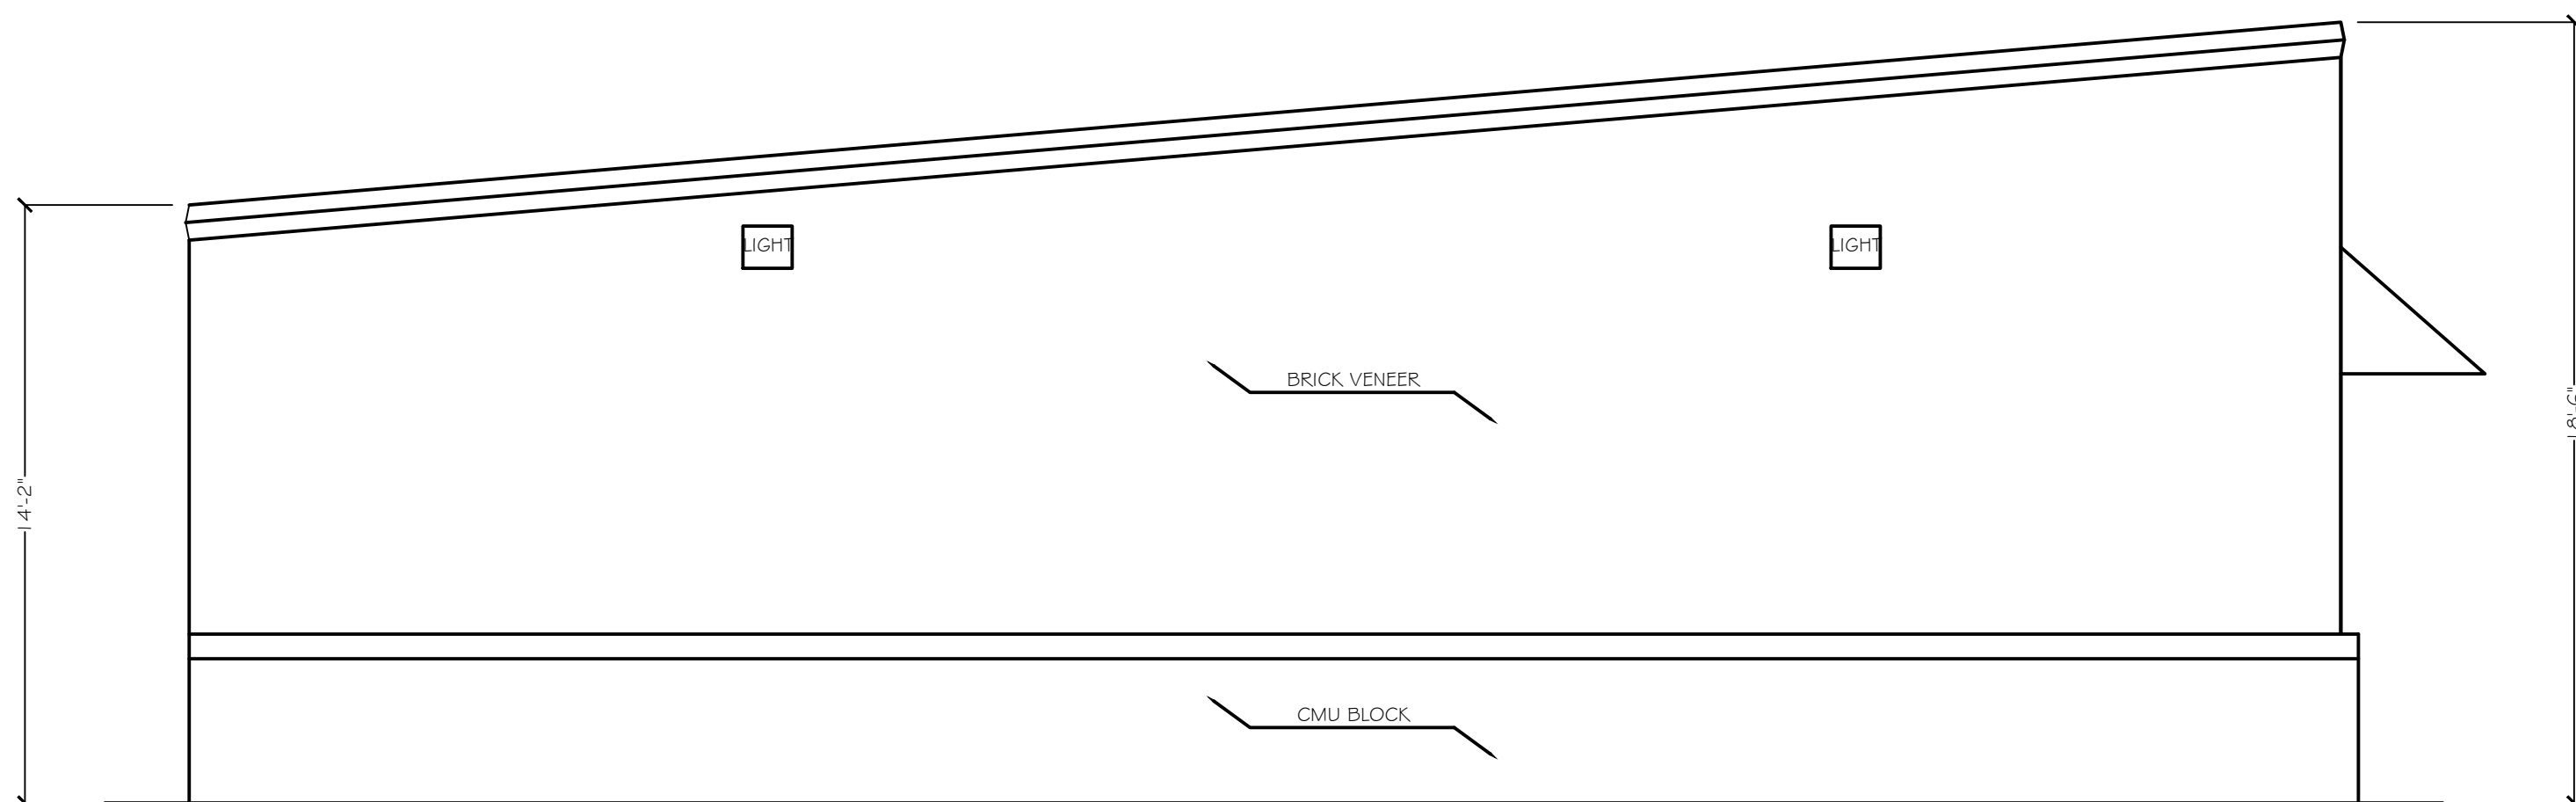

② WEST ELEVATION

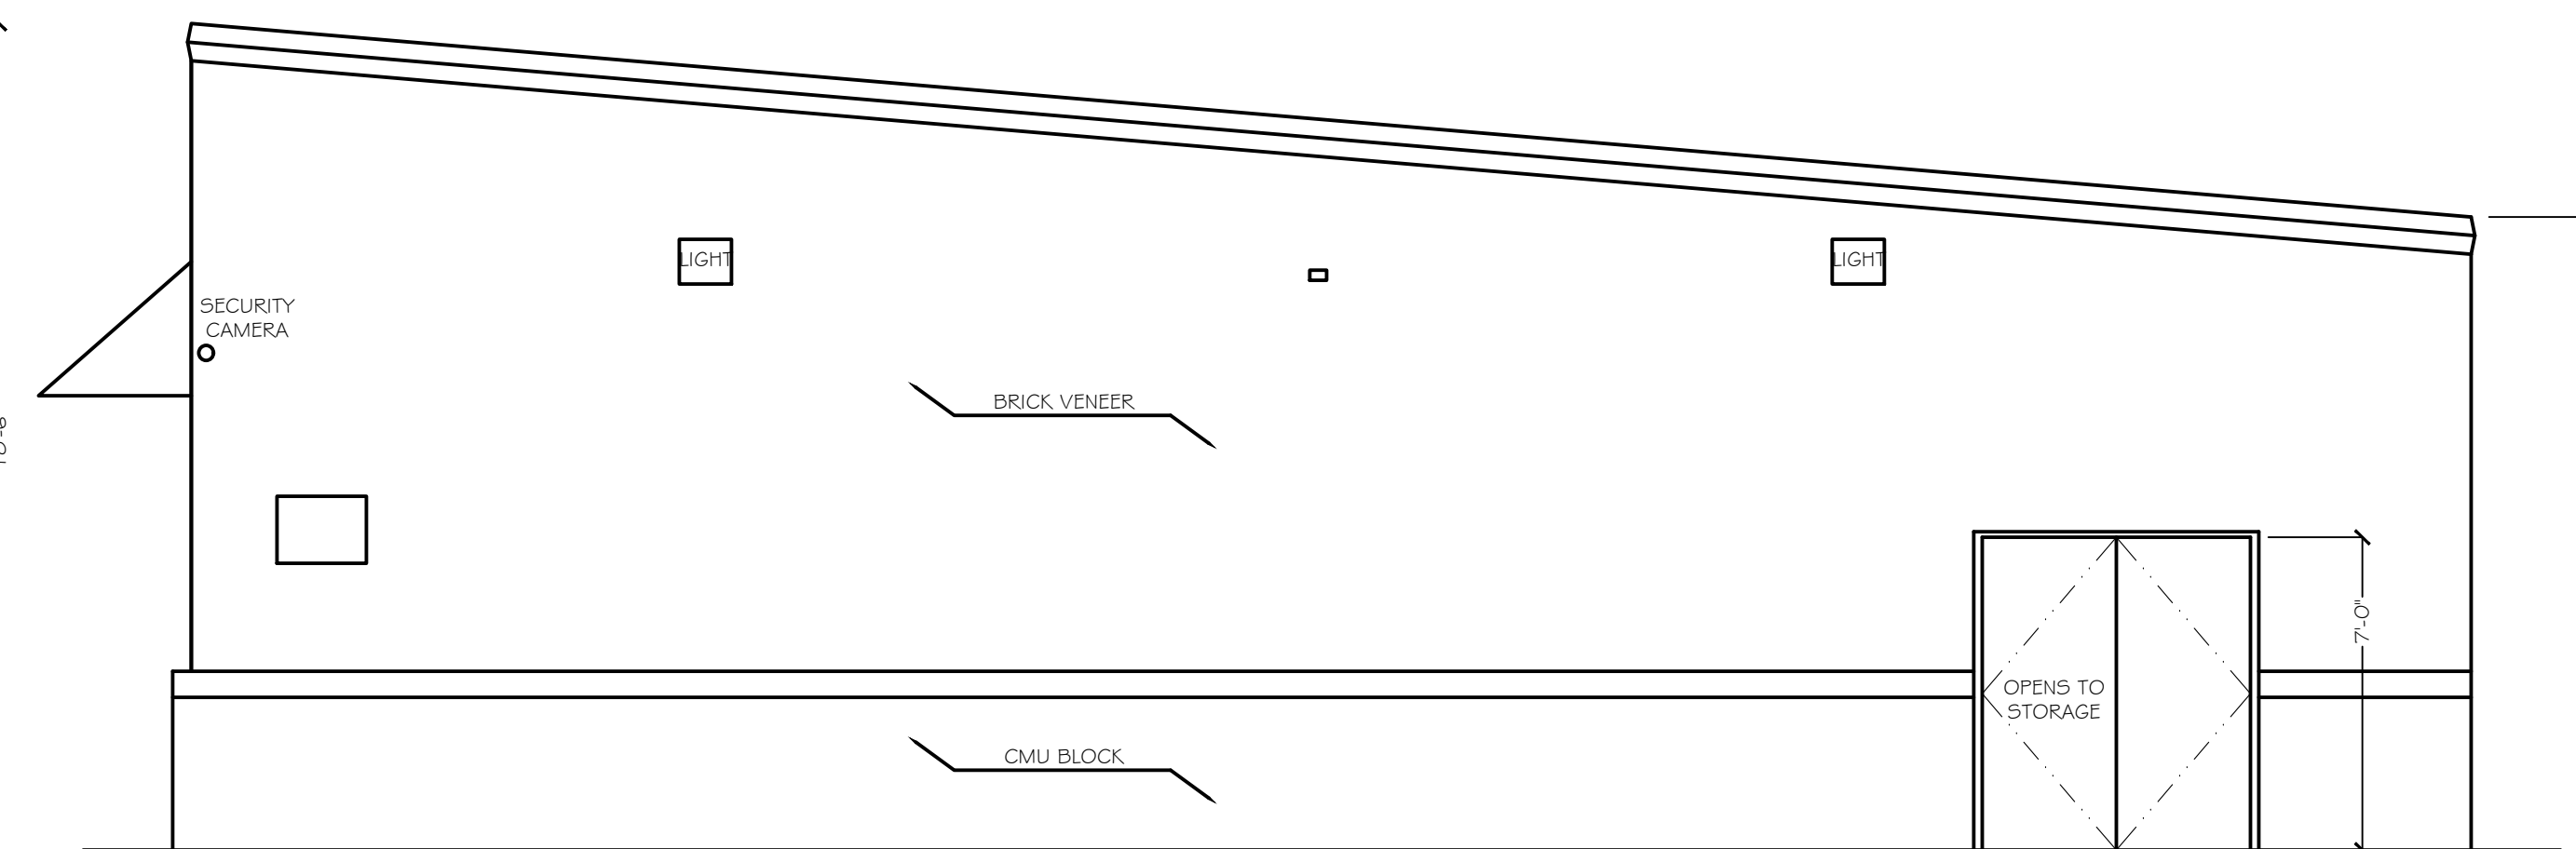

④ EAST ELEVATION

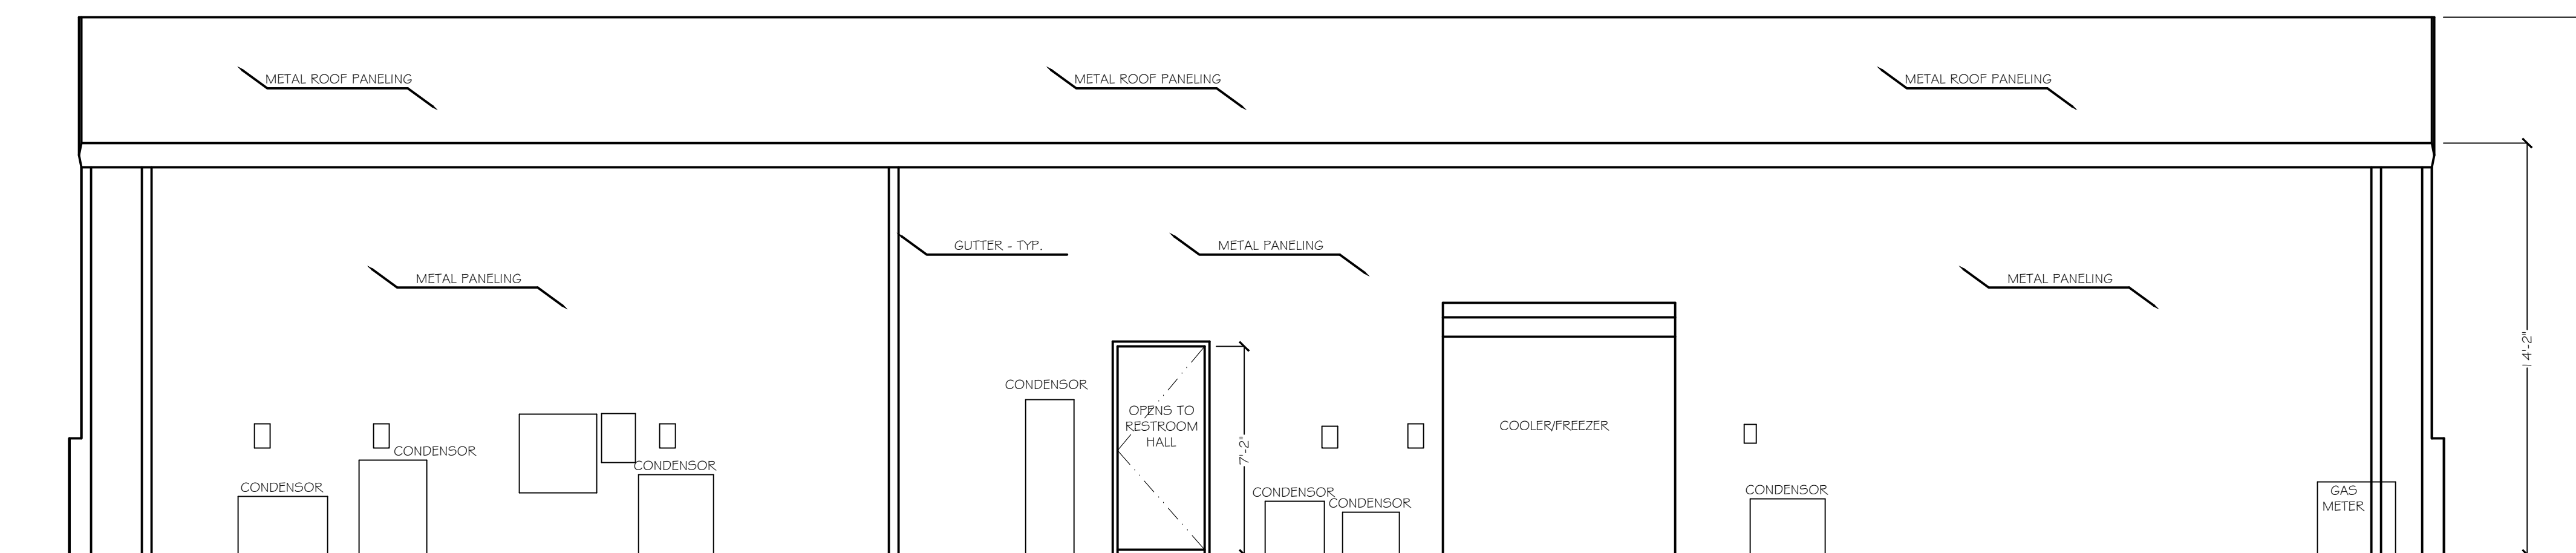

③ NORTH ELEVATION